



THE BRIDGES

G O L F C L U B

BUNKER RENOVATION PROJECT

Project Summary

APRIL 2013



JAY BLASI DESIGN
Golf Course Architecture

117 Naramore Lane -- Los Gatos, CA 95032
650.575.2419 / blasigolf@gmail.com
www.jayblasi.com

SUMMARY

Maintenance Improvements

- Replaced sand in all bunkers
- Added bunker liner to all bunkers
- Replaced drainage in all bunkers
- Replaced grass around all bunkers

Playability Improvements

- Replaced sand in all bunkers
- Reshaped all bunkers for easier access
- Reshaped all bunkers for shotmaking
- Removed 25 bunkers / added fairway
- Softened numerous slopes on course



Strategy Improvements

- Shifted 7 bunkers to give the player more options for shots
- Added 7 bunkers to guard specific hole locations
- Recontoured slopes to provide more angles of attack

BUNKER RENOVATION PROJECT

HOLE 1

Reshaped 1st fairway bunker
Converted 2nd fairway bunker to fairway
Reshaped 1st greenside bunker
Converted 2nd greenside bunker to fairway

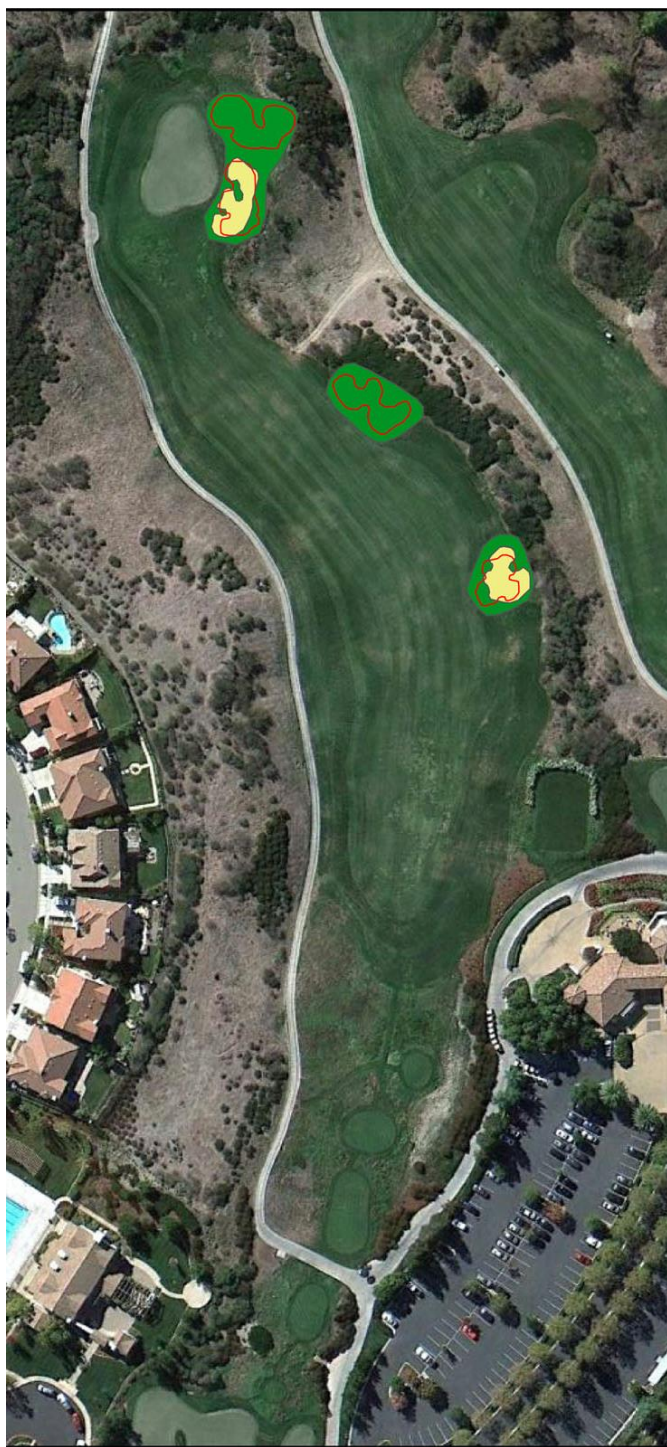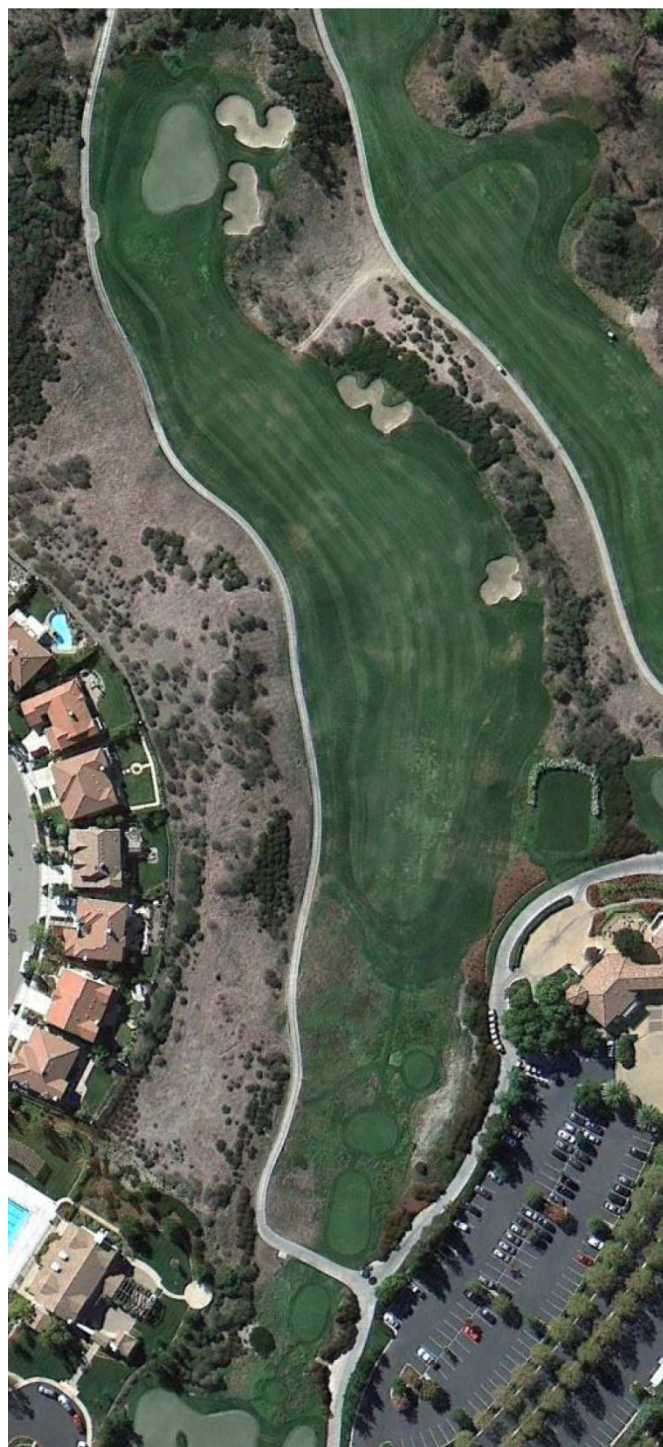

BUNKER RENOVATION PROJECT

Converted bunkers to fairway


HOLE 2



BUNKER RENOVATION PROJECT

HOLE 3

Reshaped fairway bunker
Reshaped greenside bunker

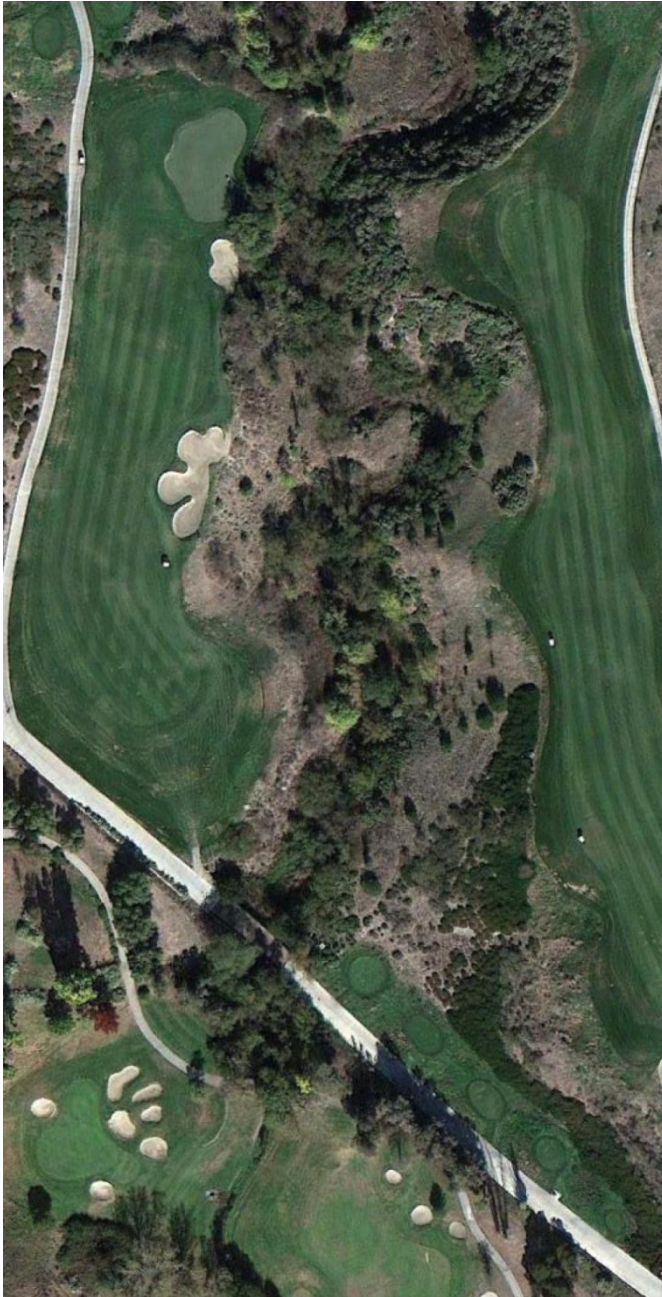

BUNKER RENOVATION PROJECT

Reshaped greenside bunker
Added fairway left of bunker


HOLE 4



BUNKER RENOVATION PROJECT

Reshaped front bunker
Converted back bunker to rough



HOLE 5

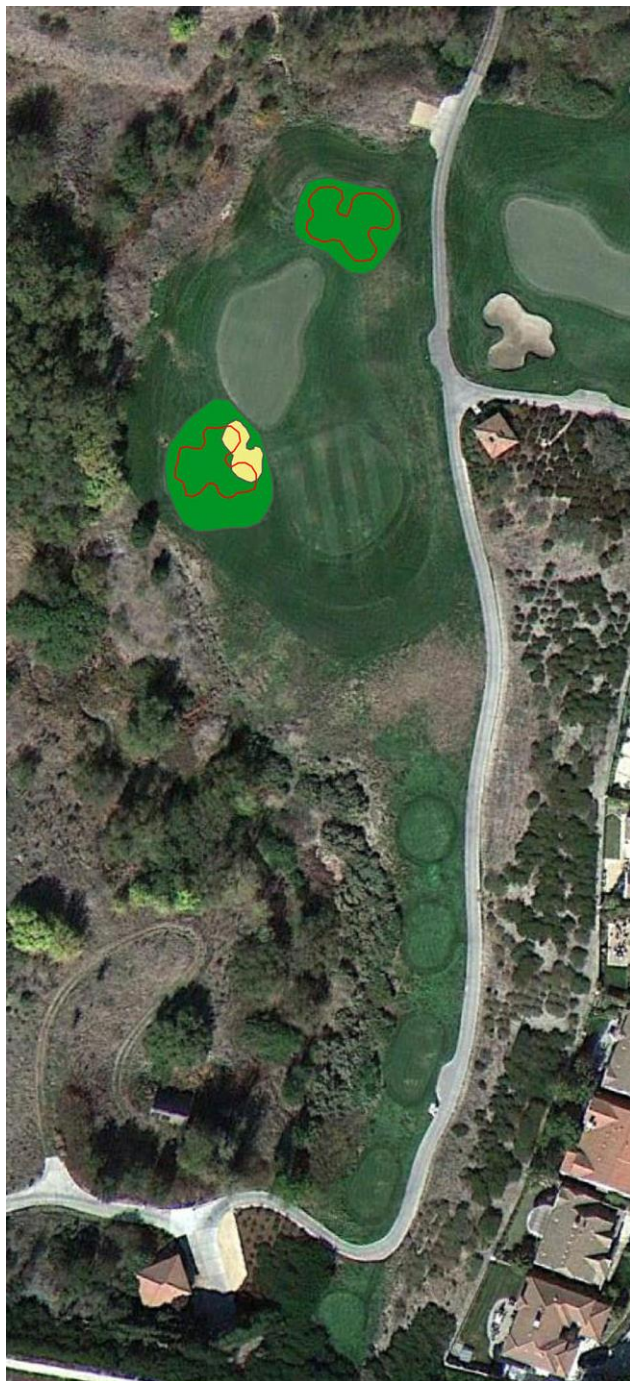

BUNKER RENOVATION PROJECT

Converted fairway bunkers to fairway
Reshaped greenside bunker
Softened hill left of green


HOLE 6

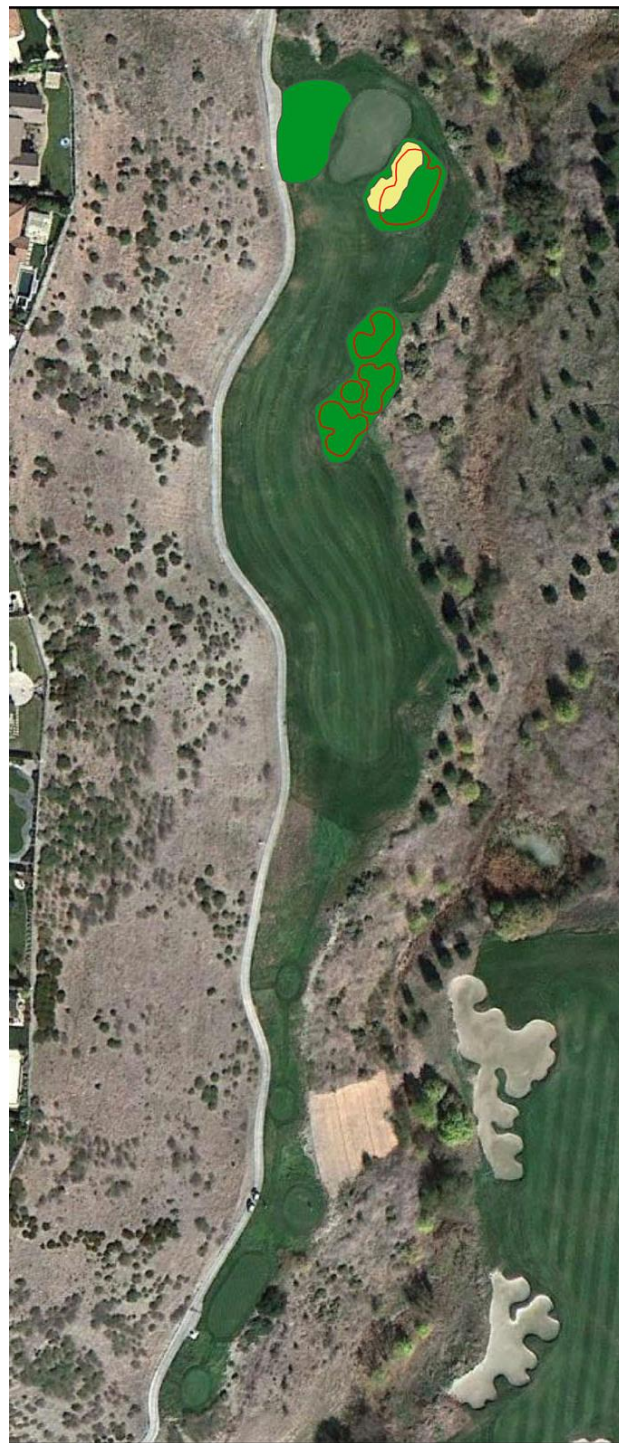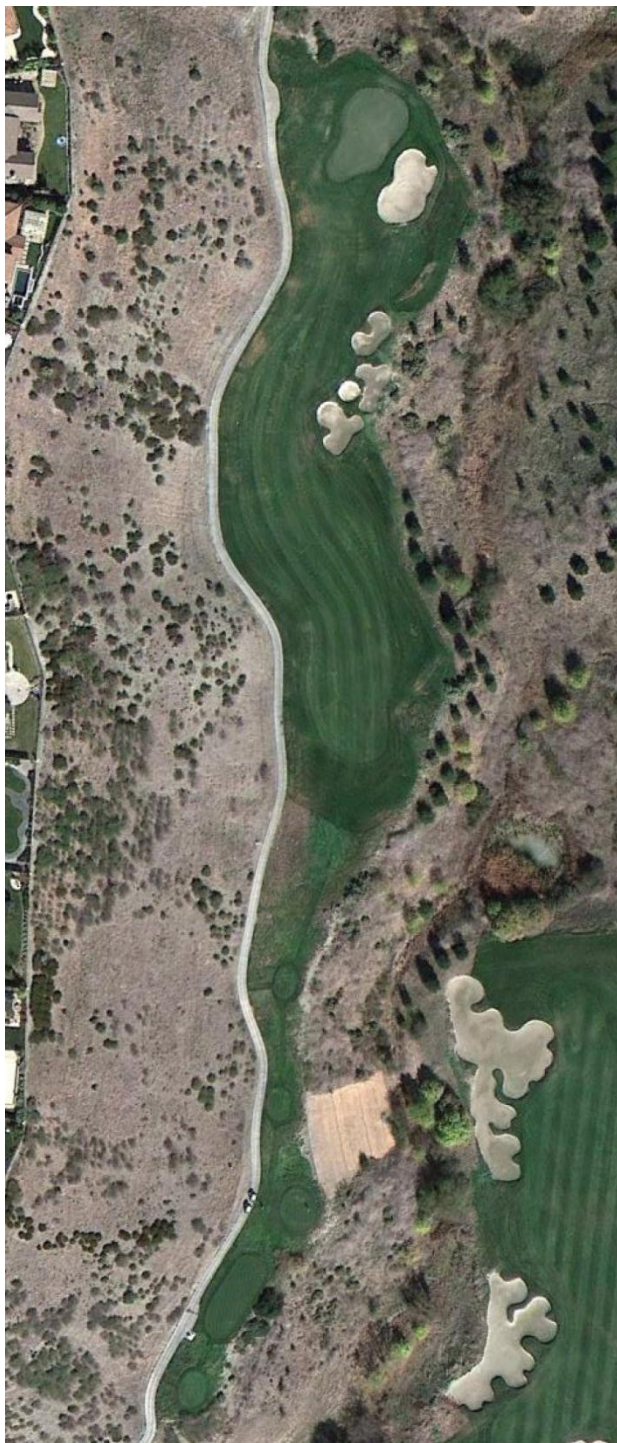

BUNKER RENOVATION PROJECT

HOLE 7

Converted left bunker to fairway
Reshaped back bunkers
Converted back right bunker to fairway
Reshaped right bunker

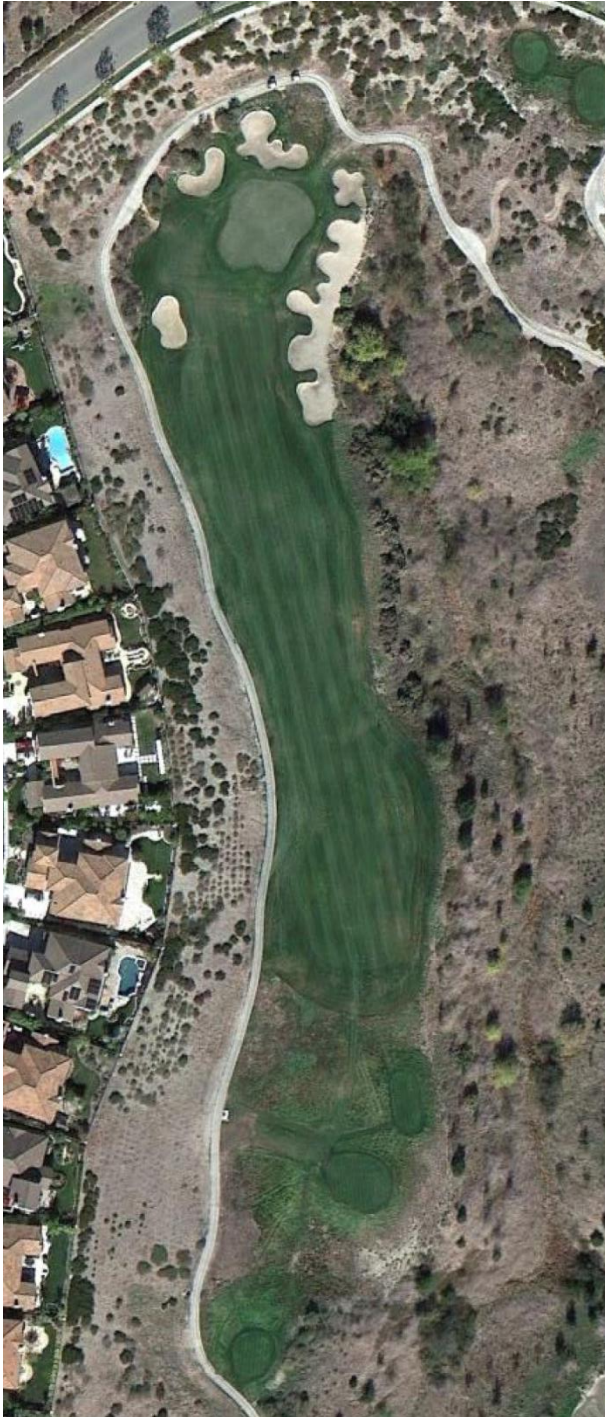

BUNKER RENOVATION PROJECT

Converted fairway bunkers to fairway
Reshaped greenside bunker

HOLE 8





THE BRIDGES
GOLF CLUB

BUNKER RENOVATION PROJECT

HOLE 9


Reduced size of bunker on right off tee
Reshaped landing area bunkers
Converted bunker short left of green to fairway
Added bunker in front of green
Converted back bunker to fairway



BUNKER RENOVATION PROJECT

HOLE 10


Added bunker just across creek
Added bunker short left of green
Reduced large bunker on right

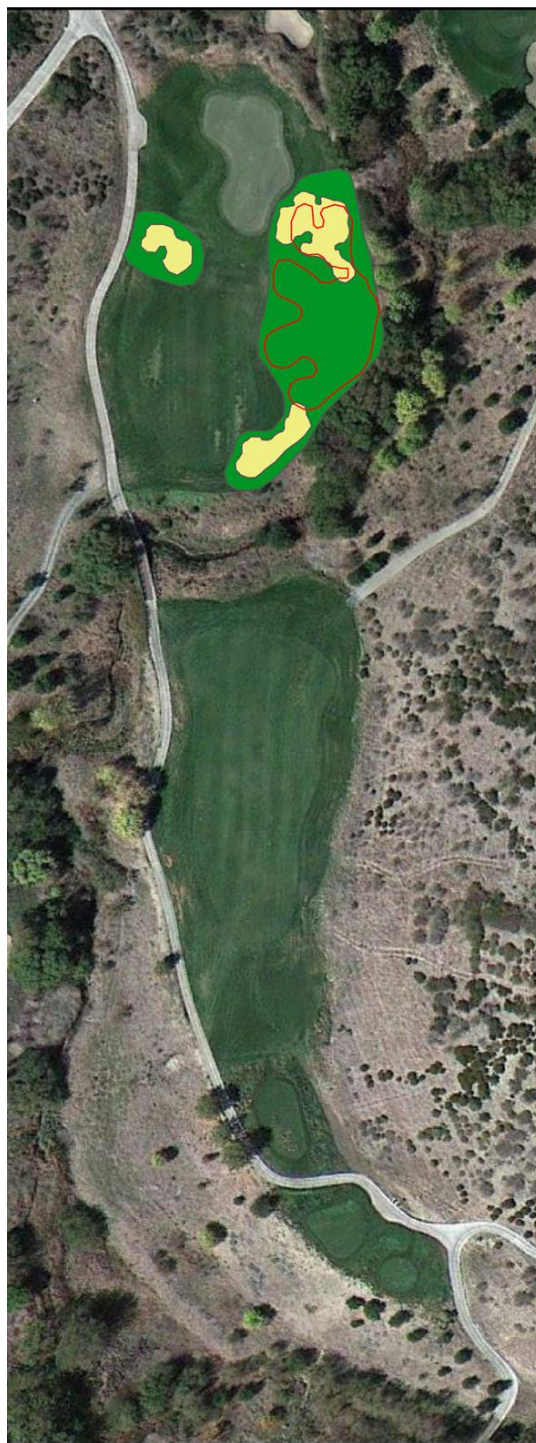

BUNKER RENOVATION PROJECT

No change

HOLE 11

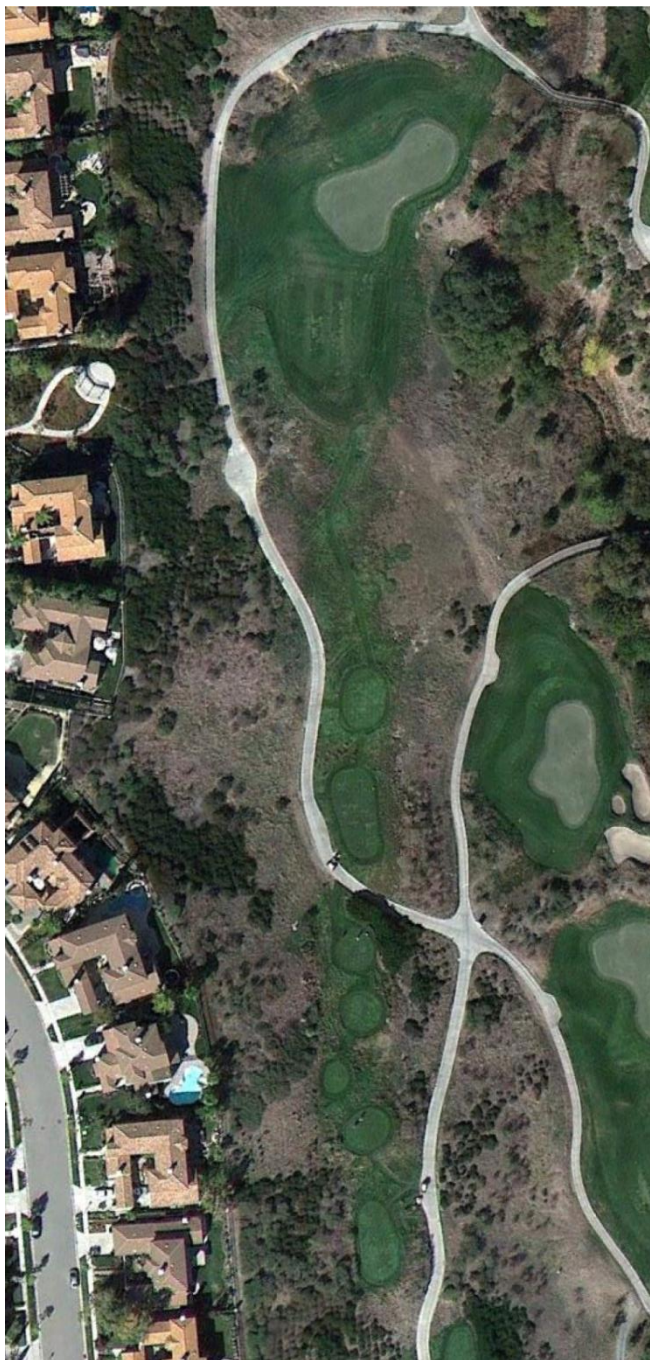

BUNKER RENOVATION PROJECT

Reshaped big bunker into 2 small ones
Added bunker right of green



HOLE 12



BUNKER RENOVATION PROJECT

HOLE 13



Converted short bunker to rough
Reshaped right bunker into two
Added small bunker in front

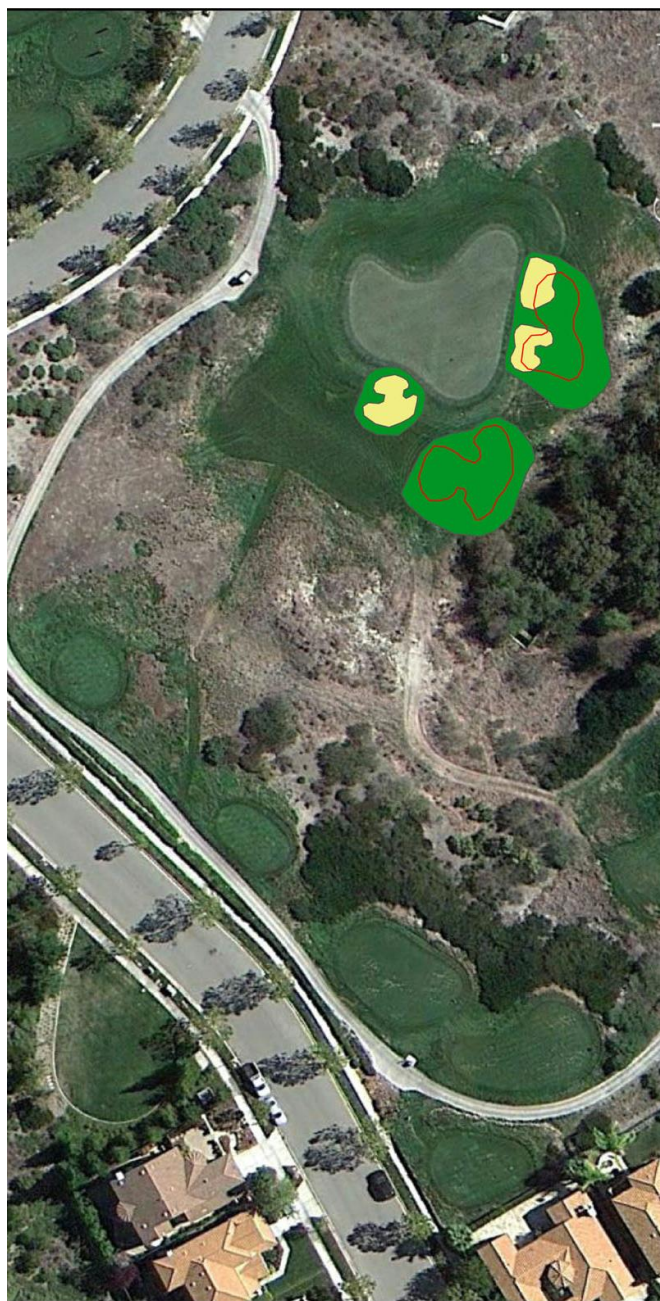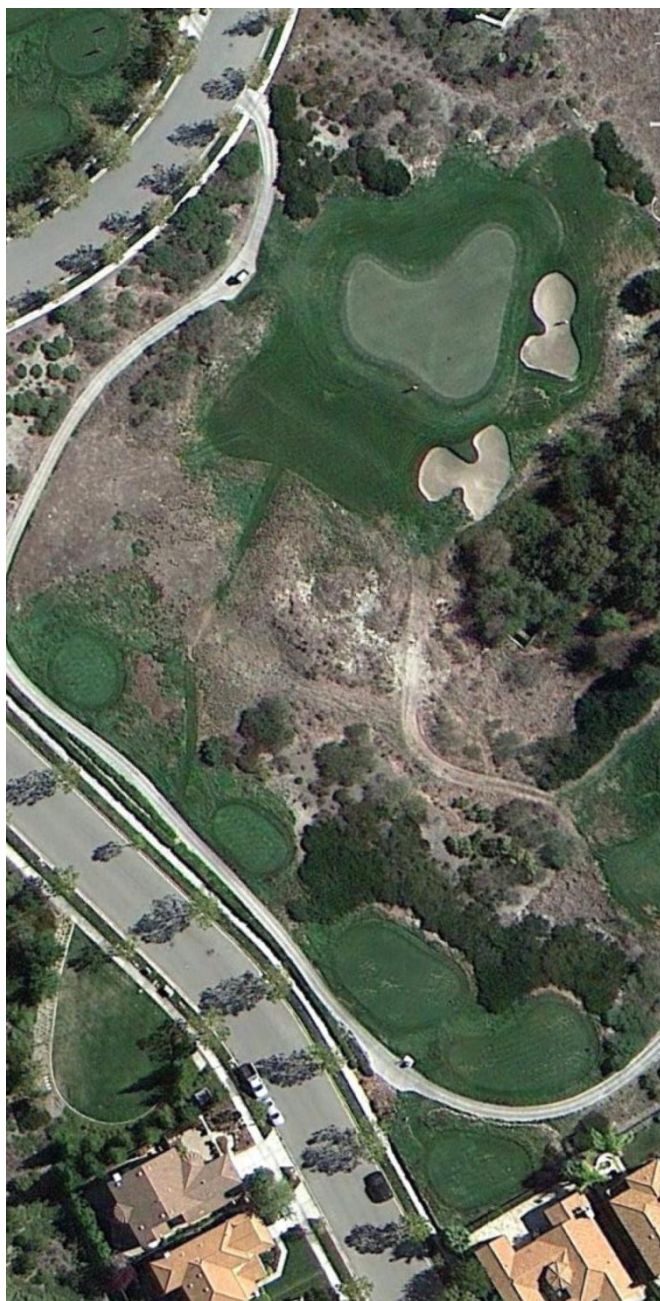

BUNKER RENOVATION PROJECT

HOLE 14


Eliminated 3 bunkers short of creek
Reshaped / added fairway short of creek
Reshaped bunkers short of green
Added bunker short left of green

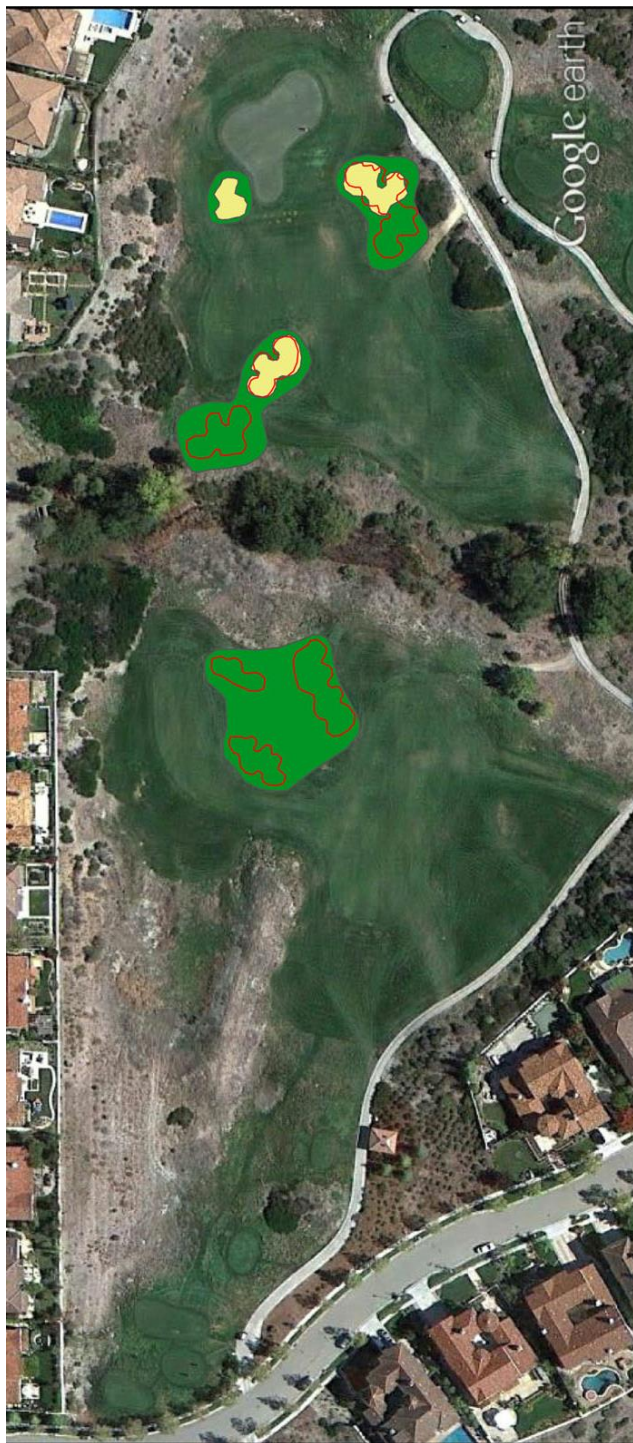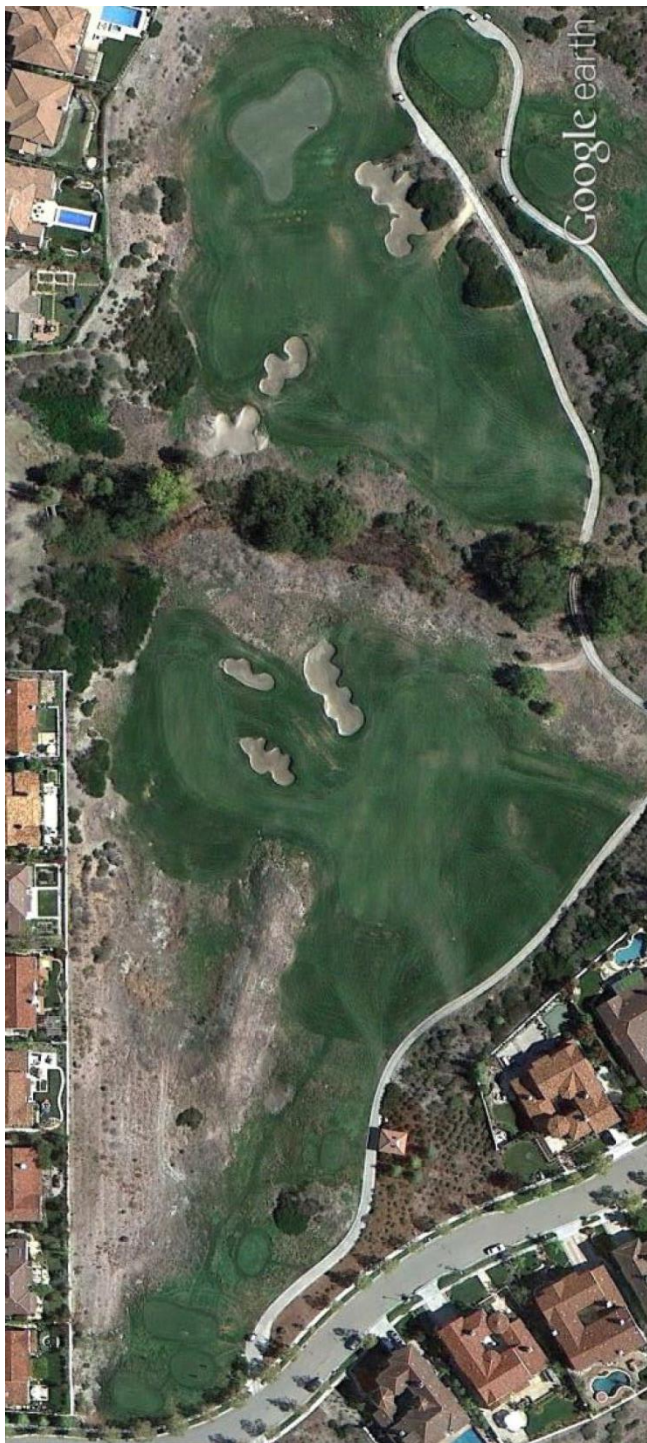

BUNKER RENOVATION PROJECT

Converted fairway bunker to fairway
Eliminated left greenside bunker
Reshaped front bunker


HOLE 15

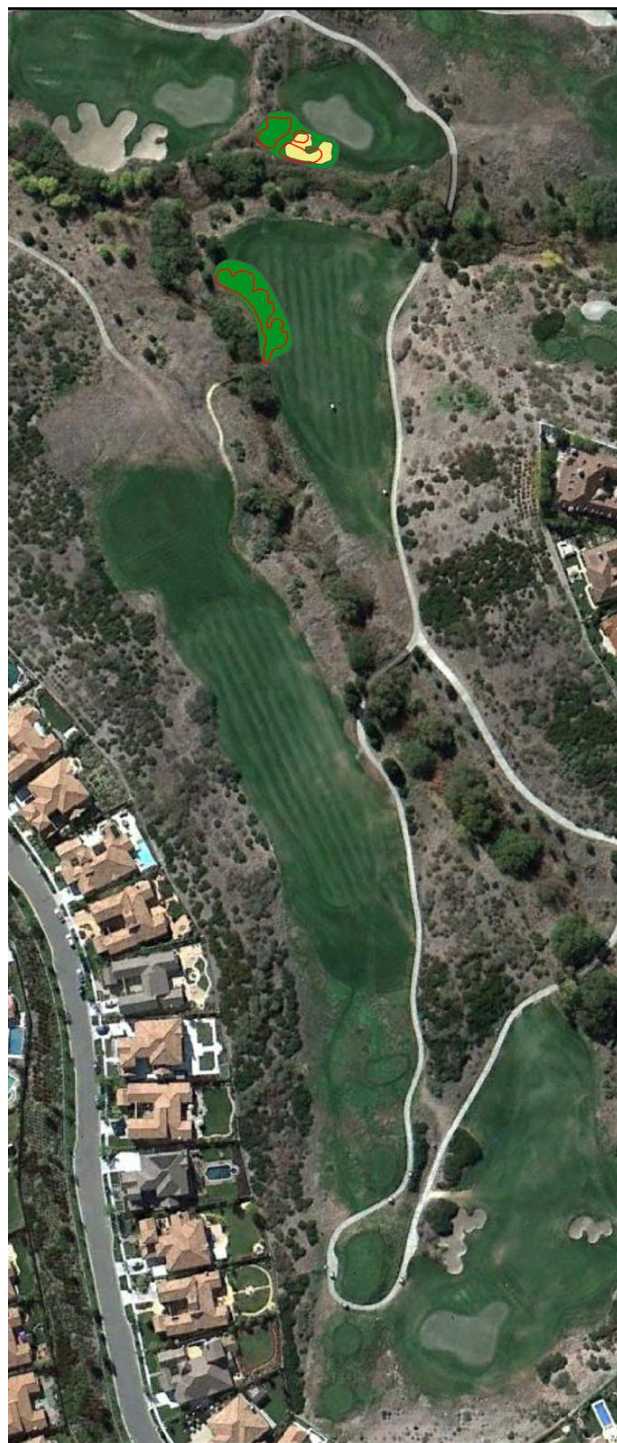

BUNKER RENOVATION PROJECT

Converted fairway bunkers to fairway
Converted back bunker to fairway

HOLE 16

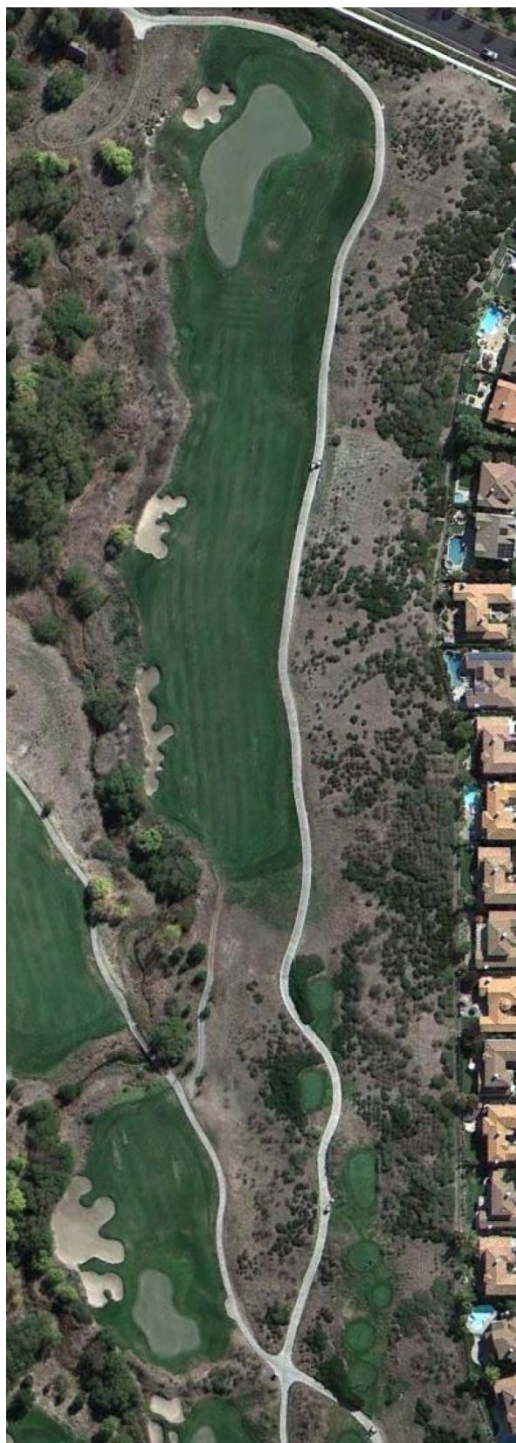

BUNKER RENOVATION PROJECT

Eliminated bunker 50 yards from green
Reshaped left bunker

HOLE 17



BUNKER RENOVATION PROJECT

HOLE 18

Reshaped fairway bunkers off tee
Reshaped 2nd landing area bunker
Converted creekside bunker to rough

